


FLOOR 5

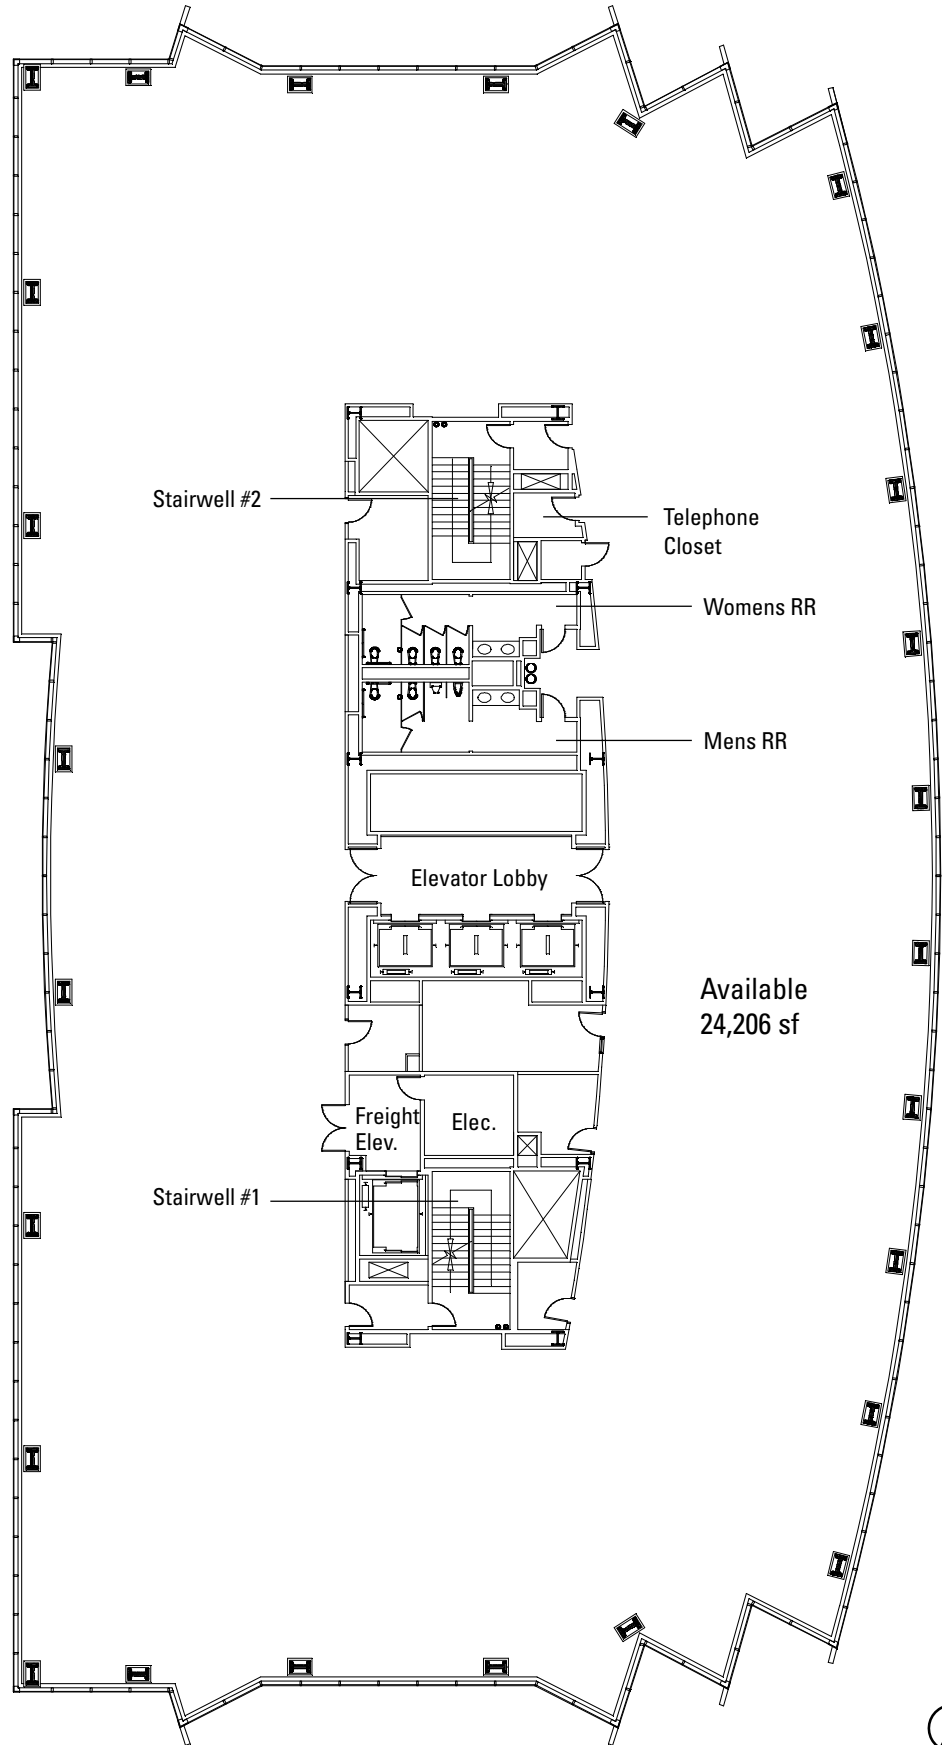

Stairwell #2

Telephone Closet

Womens RR

Mens RR

Elevator Lobby

Available
24,206 sf

Freight Elev.

Elec.

Stairwell #1




2100
POWELL
EMERYVILLE



Hines

FLOOR 5 : As Built Plan

Available
24,206 sf

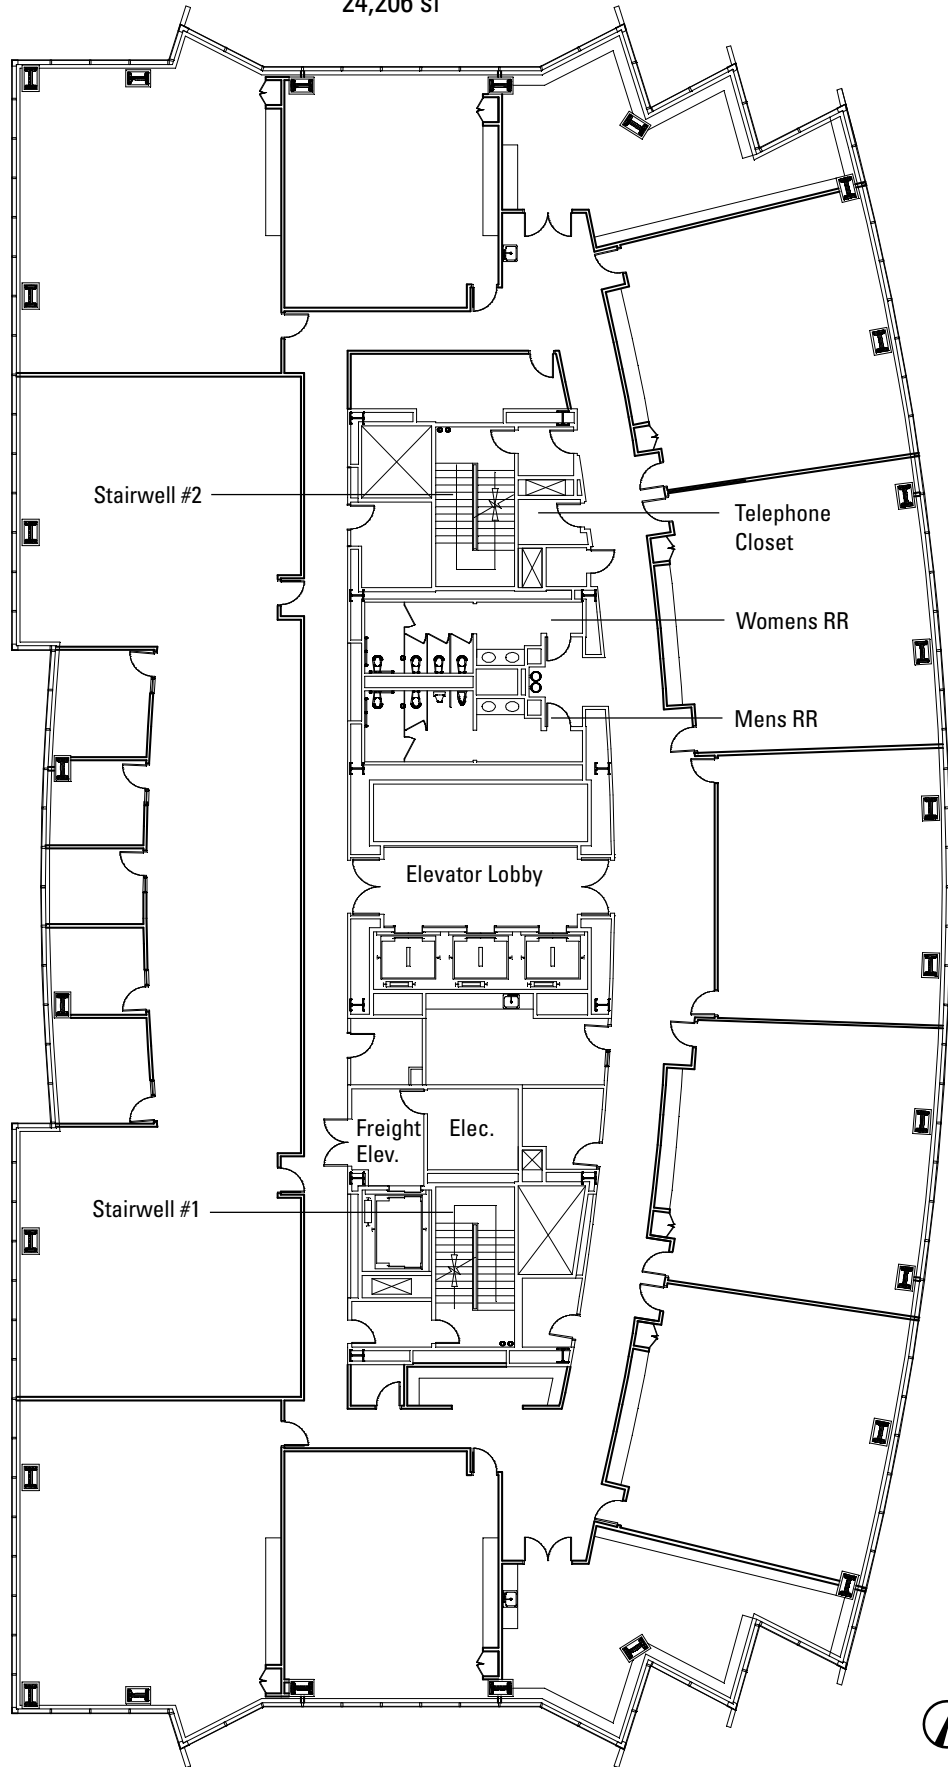

2100
POWELL
EMERYVILLE



Hines

