


FLOOR 7




2100
POWELL
EMERYVILLE

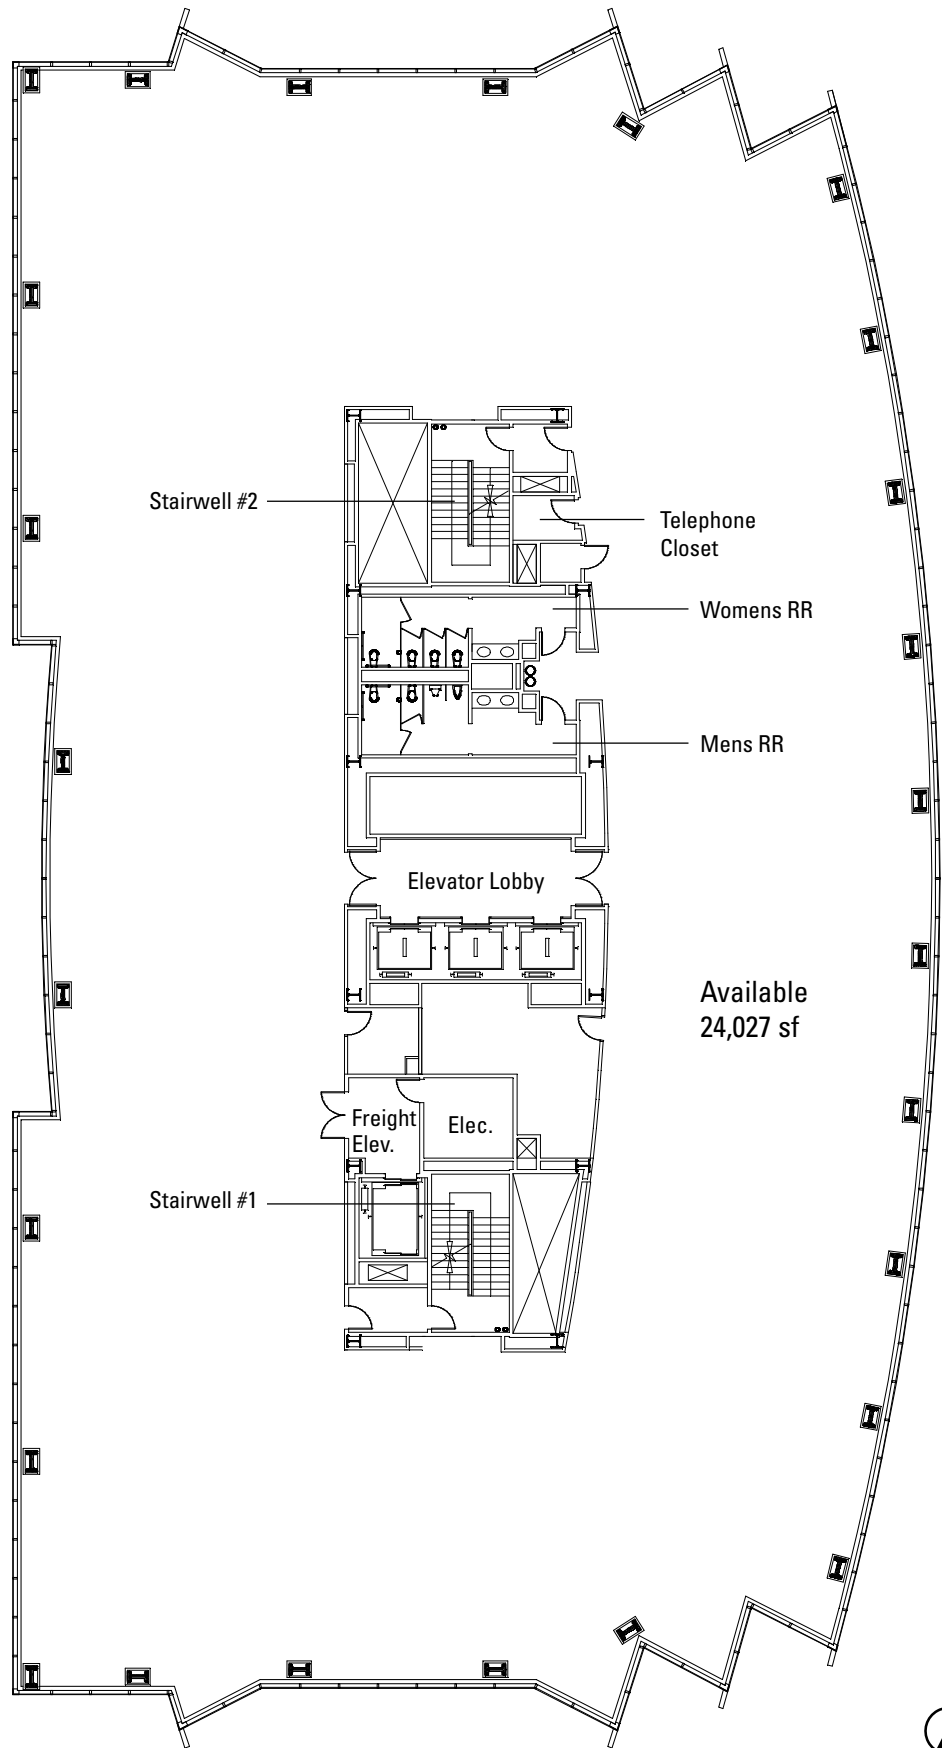

Hines

FLOOR 7 : As Built Plan

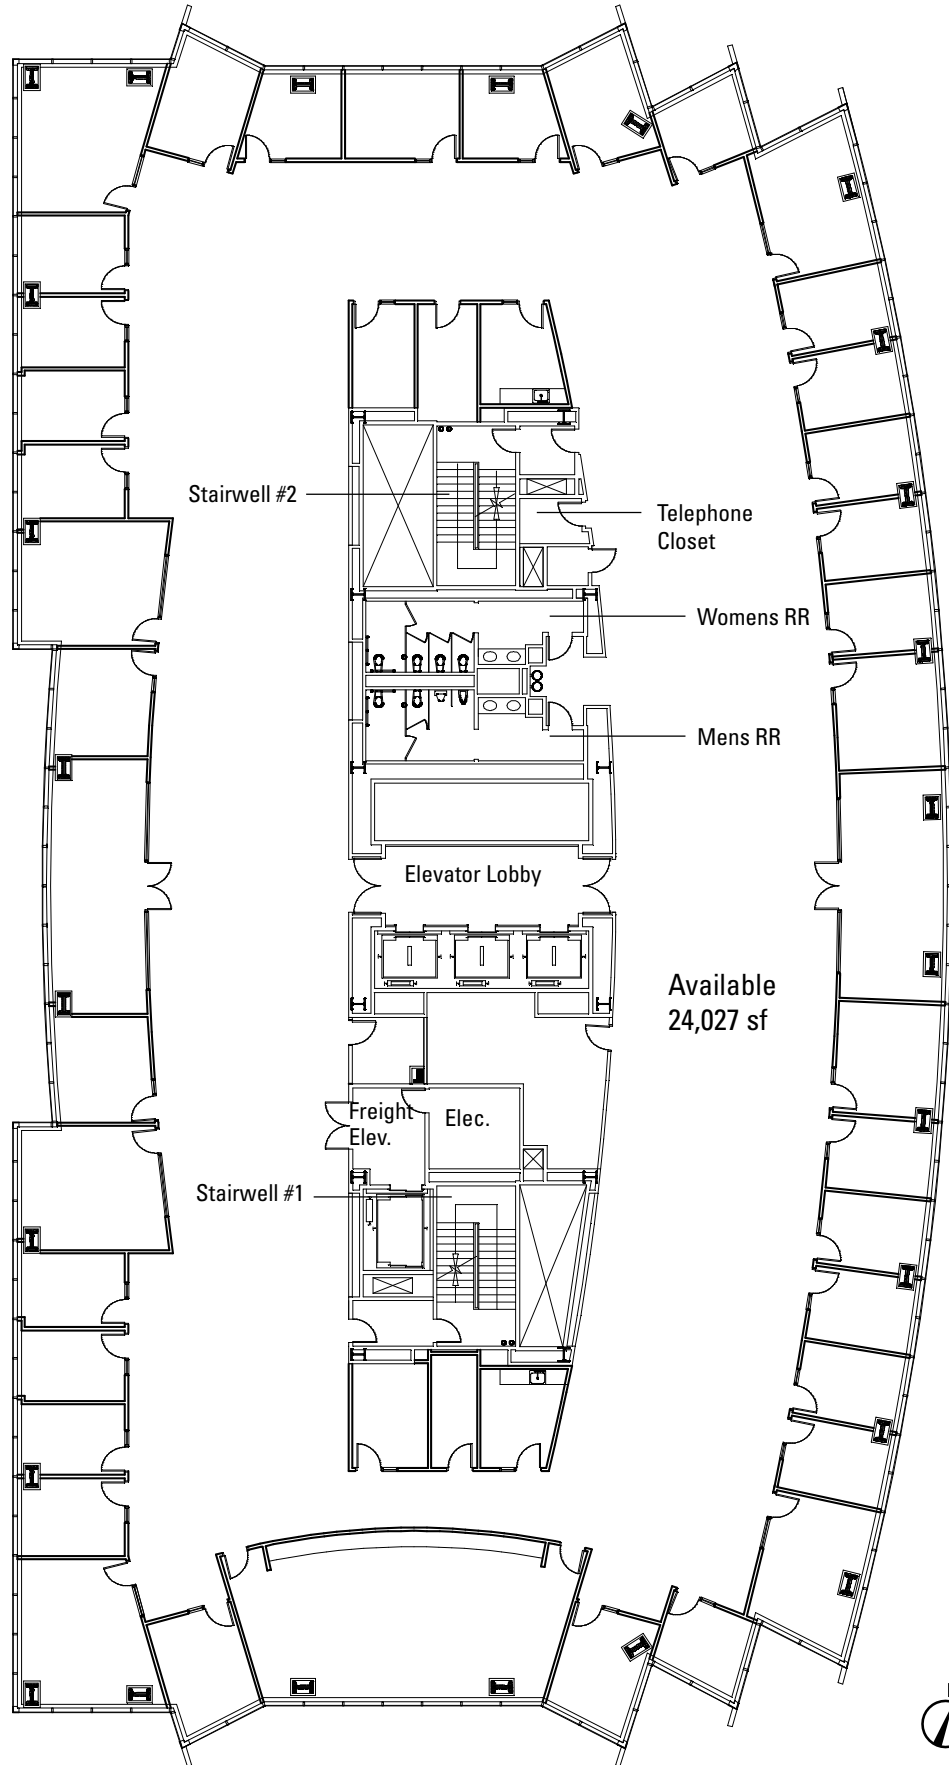

2100
POWELL
EMERYVILLE



Hines