


RIDDER PARK TECHNOLOGY CENTER

1730 FOX DRIVE ±20,000 - ±79,508 SF

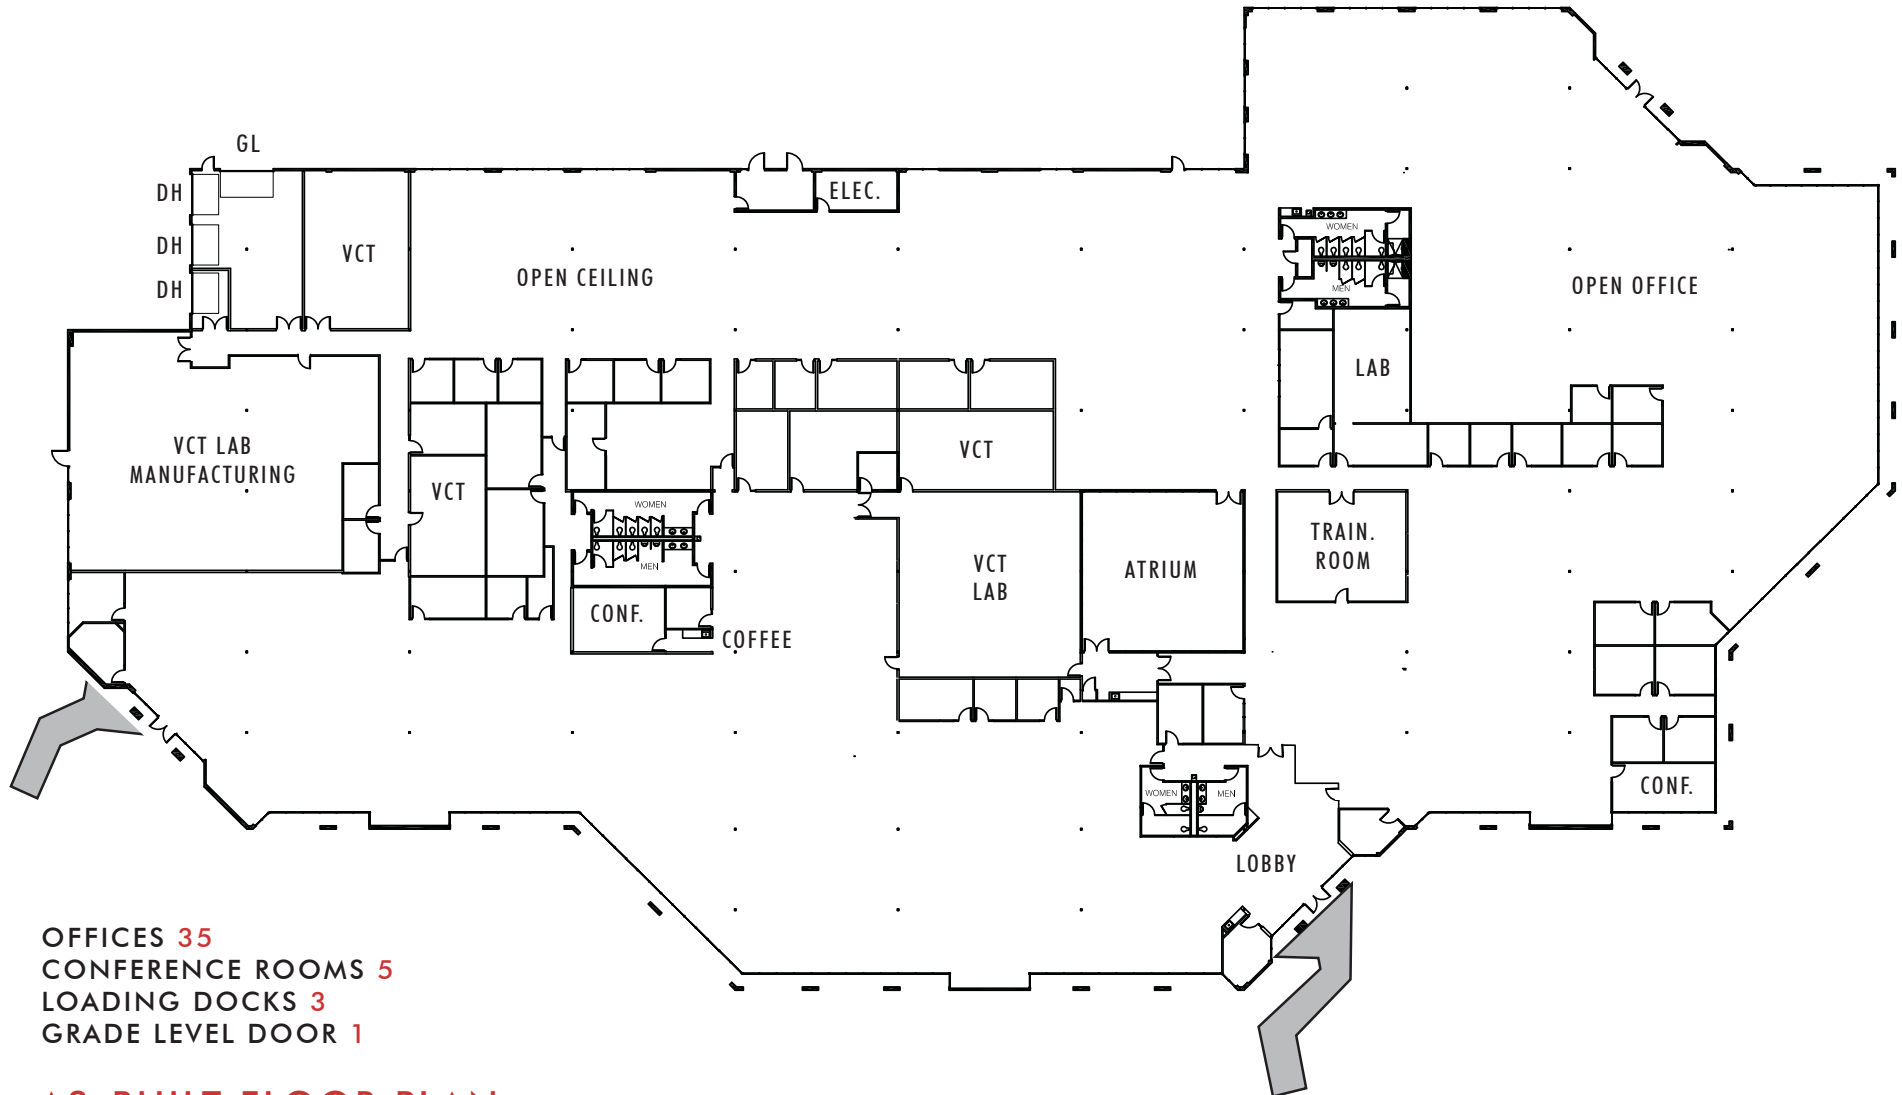

OFFICES 35
CONFERENCE ROOMS 5
LOADING DOCKS 3
GRADE LEVEL DOOR 1

AS-BUILT FLOOR PLAN
(NOT TO SCALE)

