



RIDDER PARK TECHNOLOGY CENTER

1751 FOX DRIVE ±64,943 SF

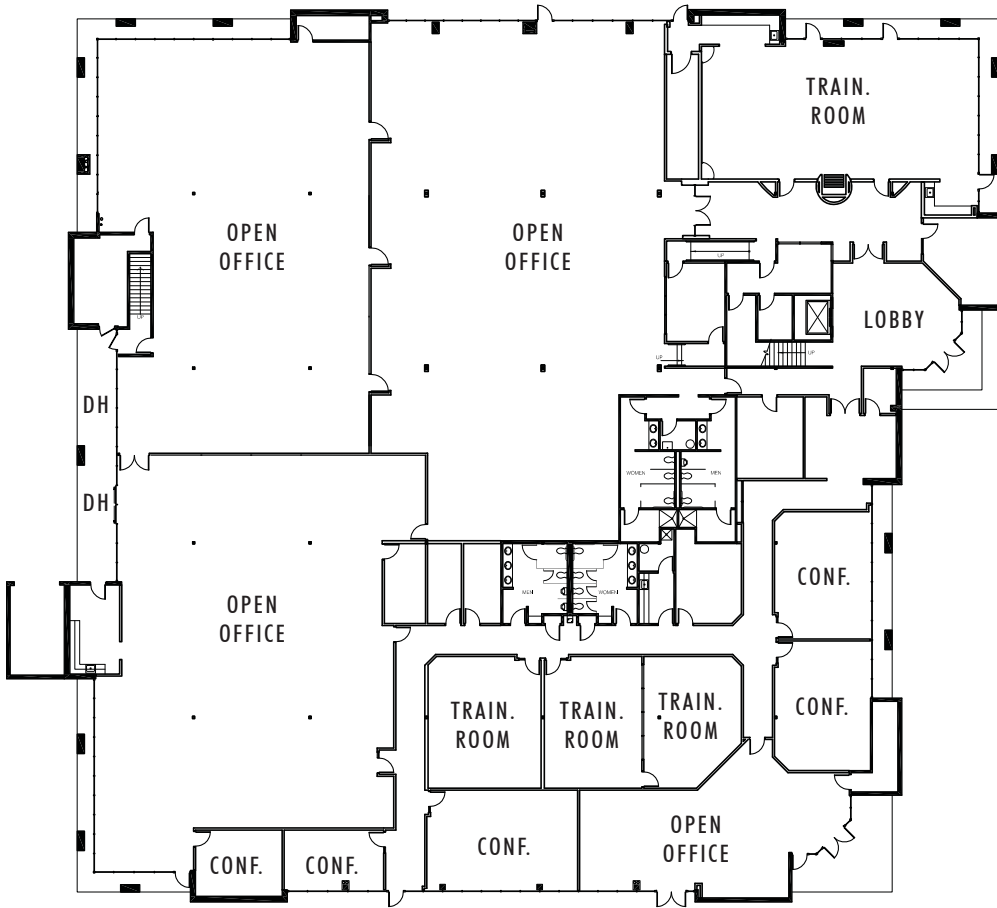

CONFERENCE ROOMS 7
TRAINING ROOMS 4

AS-BUILT FIRST FLOOR PLAN
(NOT TO SCALE)

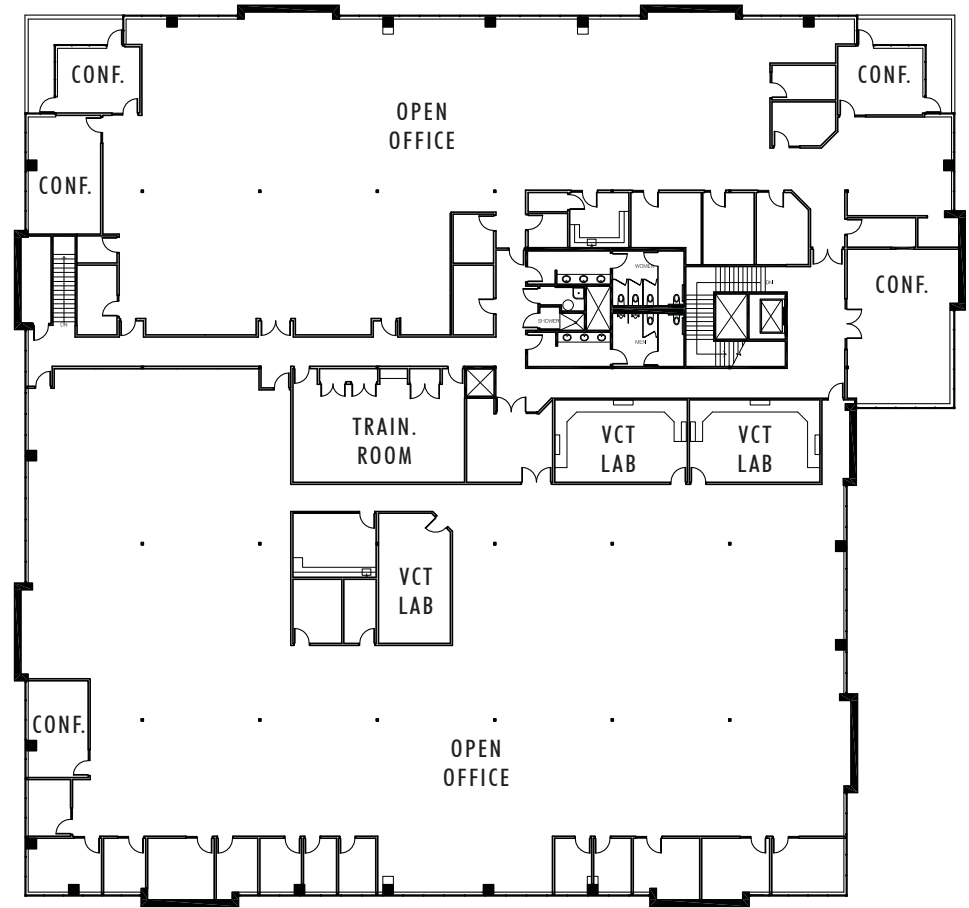

OFFICES 19
CONFERENCE ROOMS 6

AS-BUILT SECOND FLOOR PLAN
(NOT TO SCALE)

